



THIS DRAWING IS CONFIDENTIAL & THE COPYRIGHT OF PAINE MANWARING LTD. THE CONTENTS ARE NOT TO BE USED OR COPIED FOR ANY PURPOSE WHATSOEVER WITHOUT OUR PRIOR WRITTEN CONSENT

DO NOT SCALE

ALL DIMENSIONS IN MILLIMETRES EXCEPT WHERE OTHERWISE STATED

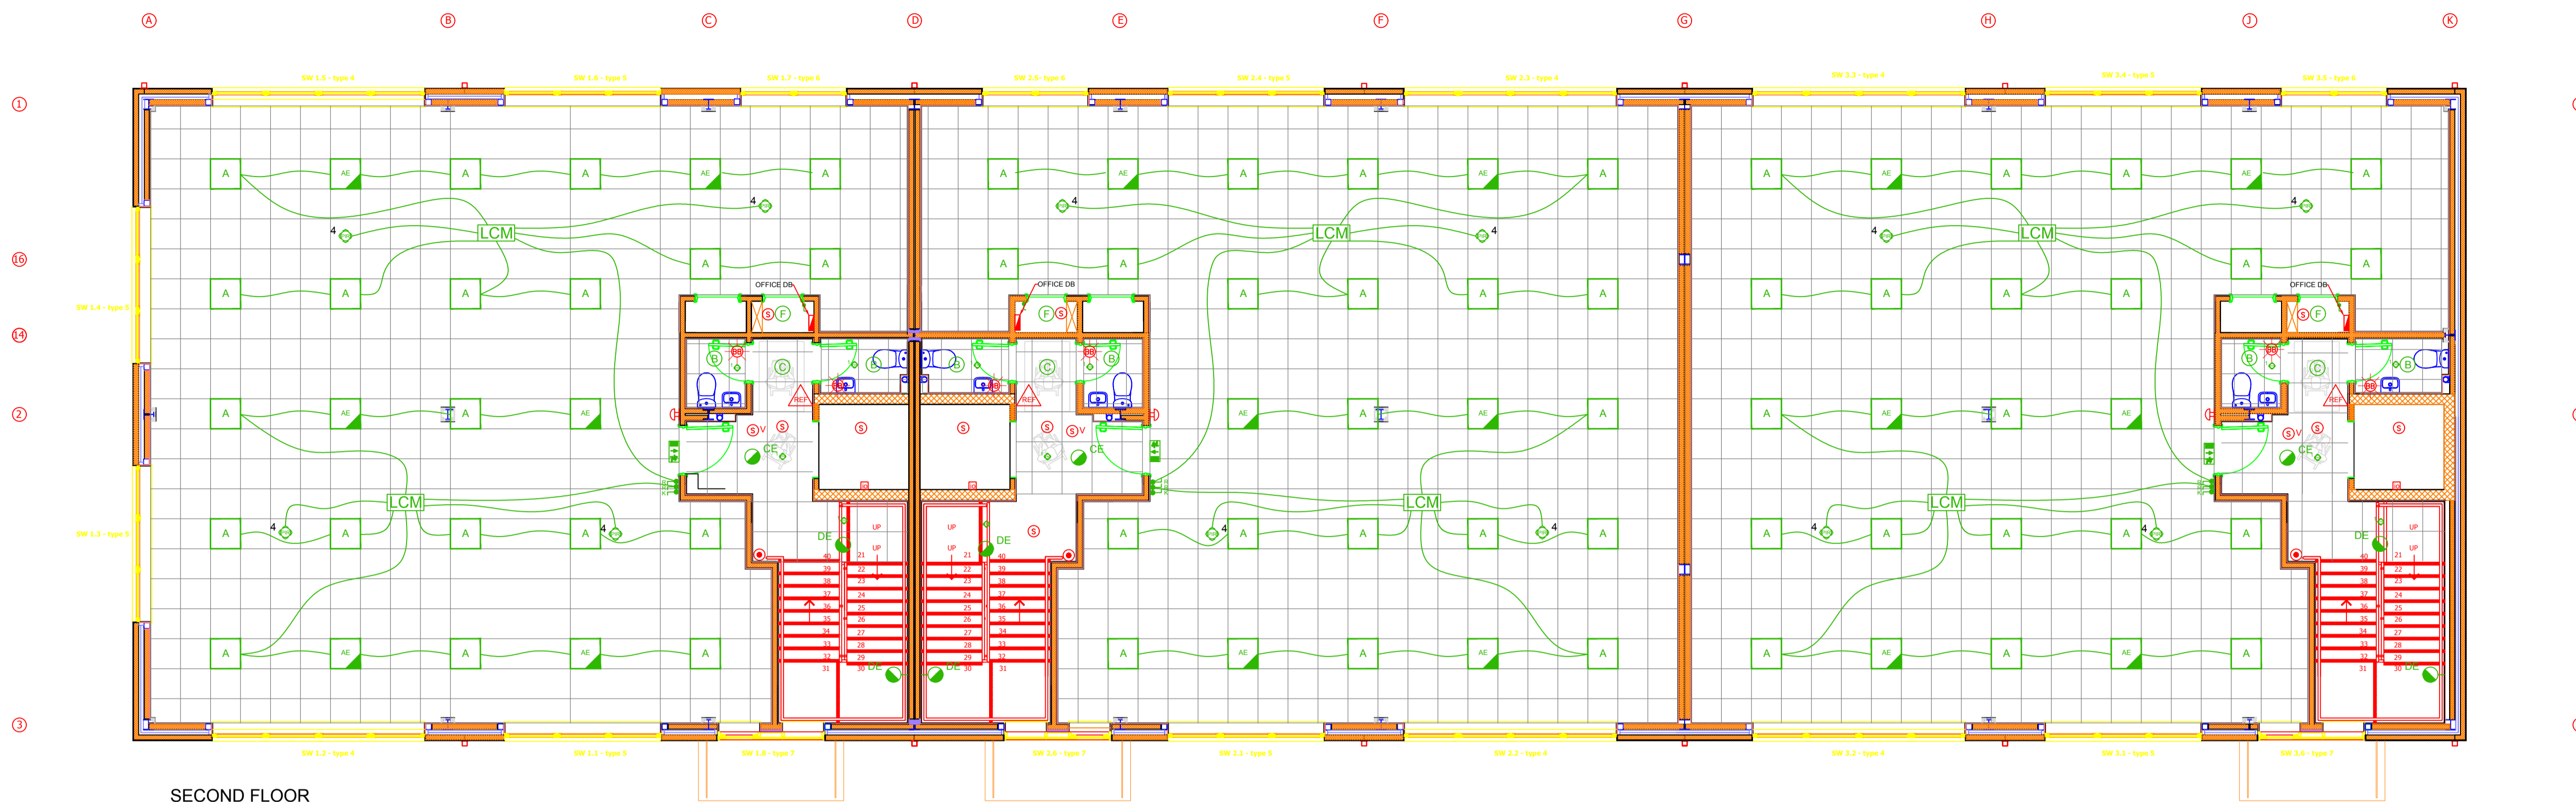

SECOND FLOOR

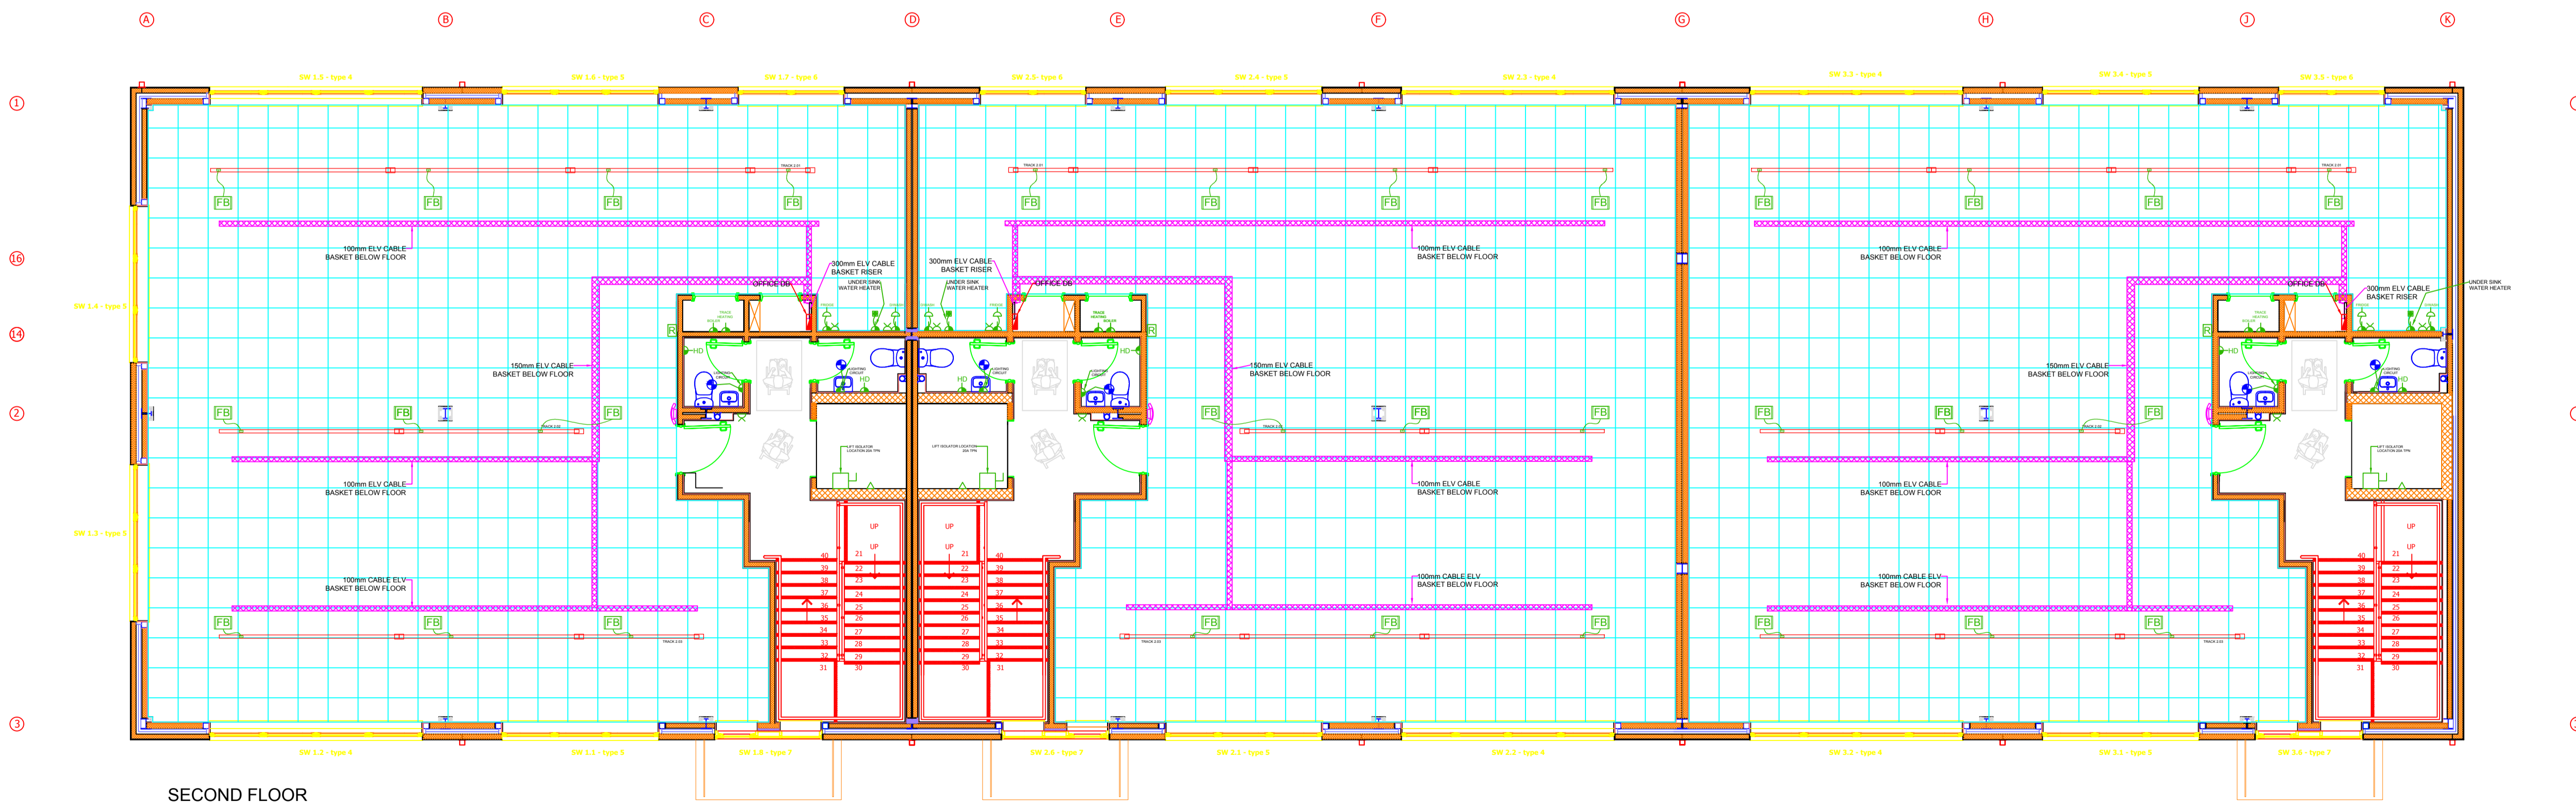

SECOND FLOOR

REV	DESCRIPTION	DATE

PAINEMANWARING
 Heating • Plumbing • Electrical
 Unit D, Easting Trading Estate
 Dominion Way, Worthing
 West Sussex BN14 8HQ
 Tel: (01903) 237522
 Fax: (01903) 236511
 Email: enquiries@paimanwaring.co.uk
 Web: www.paimanwaring.co.uk

STATUS: RECORD DRAWING

CLIENT: W. STIRLAND

PROJECT: BLOCK B SOUTHERN GATE
 SOUTHERN SIDINGS CHICHESTER

TITLE: ELECTRICAL SERVICES
 SECOND FLOOR
 ELECTRICAL SERVICES

SCALE	DESIGNED
1:75@A1	BWL
CONTRACT NUMBER	DRAWN
EC4495	BWL
DATE	CHECKED
MAY 2017	AP
DRAWING NUMBER	REVISION
EC4105-E802	RD