

GENERAL NOTES
This drawing is the property of RPF Projects ltd and is not to be copied, reproduced, retained or disclosed to any unauthorised person, either wholly, electronically or in part without the written consent of RPF Projects ltd.

ILLUSTRATED BRIEF
Any drawing prefixed with L1 in the drawing title block
must not in any way be used on site as a construction
drawing or used for final detailed costing.

MAINTENANCE NOTES

		DECEM	0	L
	PRODUCT	EDDI TI		-
	LUMENS	3000Lm		1
	WATTS	35W		-
2 2	COLOUR TEAP	1500°Y		4
	REFLECTOR			4
		MEDIUM REFLECTOR		4
		COLDUR WHITE		1
	DIMENSIONS	LENGTH	156mm	1
		WIDTH	13mm	
		HEIGHT	165mm]
121 - 2080		CUT OUT	NA.	
	PRODUCT	EDDI GIME	AL CIRC	
	LUMENS	2000.m		1
	WATTS	21W		1
	COLDUR TEMP	3500°K		1
r Po	REFLECTOR	CYTRA WID	E REFLECTOR	1
4	COLDUR	WHITE		1
	DIMENSIONS	DELMETER 176mm		1
		HEIGHT	109mm	1
	1	CUT OUT	150mm	i
180 6327	1	1	1	1
200 8847	PRODUCT	EDOI GIMB	N CHC	
	LUMENS	2000L/N	~ UNC	
	WATTS	21W		
1	COLOUR TEMP	1500°K		
47	REFLECTOR	WIDE REFL	ECTOR	
	COLDUR	WHITE		
	DIMENSIONS	DIAMETER	176mm	
	200000000000000000000000000000000000000	HEIGHT	109mm	
		CUT OUT	150mm	
180-6326			1	
	PHODUCT	350mA 14.3	SW Downlight	
	LUMENS	9008m		
	WATTS	14.5W		
	COLDUR TEMP	3000°K		
n.	REFLECTOR	7000 1		
-	COLOUR	WHITE		
	DIMENSIONS	DEAMETER 76mm		
	DIMENSIONS	HEIGHT	48mm	
		CUT OUT	100mm	
207-6415		CUT OUT	100mm	
207-6415		-		
	PAGDUCT	EDDI DOWA	NUGHT	
		3000Lm		
	LUMENS			
	WATTS	19W		
	WATTS COLOUR TEAM?	3500°K		
(2)	WATTS COLOUR TEMP REFLECTOR	35W 3500°K MEDRUM RE	FLECTOR	
②	WATTS COLOUR TEAP REFLECTOR COLOUR	3500°K MIDBUM RE WHITE		
	WATTS COLOUR TEMP REFLECTOR	3500°K MEDRUM RE WHETE DEAMETER	115mm	
•	WATTS COLOUR TEAP REFLECTOR COLOUR	3500°K MEDRUM RE WHETE DEAMETER HEIGHT	115mm 109mm	
	WATTS COLOUR TEAP REFLECTOR COLOUR	3500°K MEDRUM RE WHETE DEAMETER	115mm	
268 voca	WATTS COLOUR TEMP REFLECTOR SOLOUR DIMENSIONS	3500°K MEDRUM RE WHETE DEAMETER HEIGHT	115mm 109mm	
	WATTS COLOUR TEAM REFLECTOR COLOUR COLOUR DRAFENSIONS	3500°K MEDRUM RE WHETE DEAMETER HEIGHT	115mm 109mm 100mm	
	WATTS COLOUR TEAM REFLECTOR COLOUR DIMENSIONS PRODUCT TIME	3500°K 3500°K MEDRUM RE WHITE DEAMETER HEIGHT CUT OUT	115mm 109mm 100mm	
	WATTS COLOUR TEAM REFLECTOR COLOUR DIMENSIONS PRODUCT TIME	3500°C MEDIUM RE WHITE DEMETER HEIGHT CUT OUT	115mm 109mm 100mm	
	WATTS COLOUR TEMP REFLECTOR COLOUR DIMENSIONS PRODUCT TIME: WATTS	3500°K 3500°K MEDRUM RE WHATE DEAMETER HEIGHT CUT OUT EMERGENC 3 nour non- 2W	115mm 109mm 100mm	
	WATTS COLOUR TEMP REFLECTOR COLOUR DIMENSIONS PRODUCT TIME WATTS COLOUR TEMP	35W 350CY MEDIUM RE WHITE DEALETER HEIGHT CUT OUT EMERGENC 3 Nour non- 2W 6200YC	115mm 109mm 100mm	
	WATTS COLOUR TEMP REFLECTOR DIMENSIONS PRODUCT TIME WATTS COLOUR TEMP REFLECTOR	3500°X 3500°X MEDIUM RE WHITE DIAMETER HEIGHT CUT OUT EMERGENC 3 hour non- 2W 6200°X WIDE	115mm 109mm 100mm	
	WATTS COLOUR TEMP REFLECTOR COLOUR DIMENSIONS PRODUCT INNE WATTS COLOUR TEMP REFLECTOR COLOUR TEMP REFLECTOR	35W 350CY MEDIUM RI WHATE DIAMETER HEIGHT CUT OUT EMERGENC 3 nour non- 2W MOS WHATE	115mm 109mm 300mm v spqt montained	
	WATTS COLOUR TEMP REFLECTOR DIMENSIONS PRODUCT TIME WATTS COLOUR TEMP REFLECTOR	3500°C MIDRIM RI MATE DEMETER HEIGHT CUT OUT EMERGENC 3 nour non 2W 6200°C WHO'C WHO WHO WHO'C WHO	115mm 109mm 100mm 100mm V SPOT maintained	
	WATTS COLOUR TEMP REFLECTOR COLOUR DIMENSIONS PRODUCT INNE WATTS COLOUR TEMP REFLECTOR COLOUR TEMP REFLECTOR	35W 3500°K MIDBIUM RI WHATE PERGAT CUT OUT EMERGENC 3 nour non- 2W 6200°K WHOTE HEIGHT HEIGHT HEIGHT HEIGHT HEIGHT HEIGHT	115mm 109mm 100mm 100mm 100mm V SROT Translaned	
268 ma	WATTS COLOUR TEMP REFLECTOR COLOUR DIMENSIONS PRODUCT INNE WATTS COLOUR TEMP REFLECTOR COLOUR TEMP REFLECTOR	3500°C MIDRIM RI MATE DEMETER HEIGHT CUT OUT EMERGENC 3 nour non 2W 6200°C WHO'C WHO WHO WHO'C WHO	115mm 109mm 100mm 100mm V SPOT maintained	
	WATTS COLOUR TEMP REFLECTOR COLOUR DIMENSIONS PRODUCT INNE WATTS COLOUR TEMP REFLECTOR COLOUR TEMP REFLECTOR	35W 3500°K MIDBIUM RI WHATE PERGAT CUT OUT EMERGENC 3 nour non- 2W 6200°K WHOTE HEIGHT HEIGHT HEIGHT HEIGHT HEIGHT HEIGHT	115mm 109mm 100mm 100mm 100mm V SROT Translaned	
268-soca	WATTS COLOUR TEMP REFLECTOR COLOUR ENGLOSORS DIMENSIONS PRODUCT BING WATTS COLOUR TEMP REFLECTOR COLOUR TEMP REFLECTOR COLOUR OMNEWSIONS	15WC 150WC 1	115mm 109mm 300mm y URQY mantained 51mm 70mm 44mm	=
268 ma	WATTS REFLICTOR REPLICTOR REPLICTOR REALESTORS PRODUCT TIME WATTS COLOUR TEMP REFLICTOR	15WC 150WC 1	115mm 109mm 300mm y URQY mantained 51mm 70mm 44mm	4
268-soca	WATTS COLOUR TEAP REFLECTOR COLOUR DIMENSIONS PRODUCT TIME WATTS COLOUR TEAP REFLECTOR COLOUR TEAP REFLECTOR OBJECTOR OBJECTOR OBJECTOR OBJECTOR OBJECTOR OBJECTOR OBJECTOR	15WC 150WC 1	115mm 109mm 300mm y URQY mantained 51mm 70mm 44mm	
268-ena 263-6600 176-6600	WATTS OCIOUN TEMP REFLICTION COLOUN DIMENSIONS PRODUCT TIME UNATTS COLOUN TEMP REFLICTION COLOUN REFLICTION COLOUN TEMP REFLICTION COLOUN TEMP REFLICTION COLOUN REFLICTION COL	15WC 150WC 1	115mm 109mm 300mm y URQY mantained 51mm 70mm 44mm	4 3 3

		PG821-3	
Listing St	atus:	Conservation	on Area
		1001-75	
			1
ab	AS BUILT		27/09
Rev No.	Revision notes		Date

19-20 East St


CHICHESTER PO19 1HS

AS BUILT Ground Floor Reflected Ceiling Plan


Scale: 1/50@A1 - 1/100@A3	Date: 27/09/16	
Project No. 02-154	Drawn by: DJC	
Dwg No. 02-154-101	Revision: ab	



Unit B. Bassingbourn Gashouse, 70 High Street, Bassingbourn, Royston, Hertfordshire SG8 5LF T: 01763 243664 E: info@rpfprojects.com www.rpfprojects.com

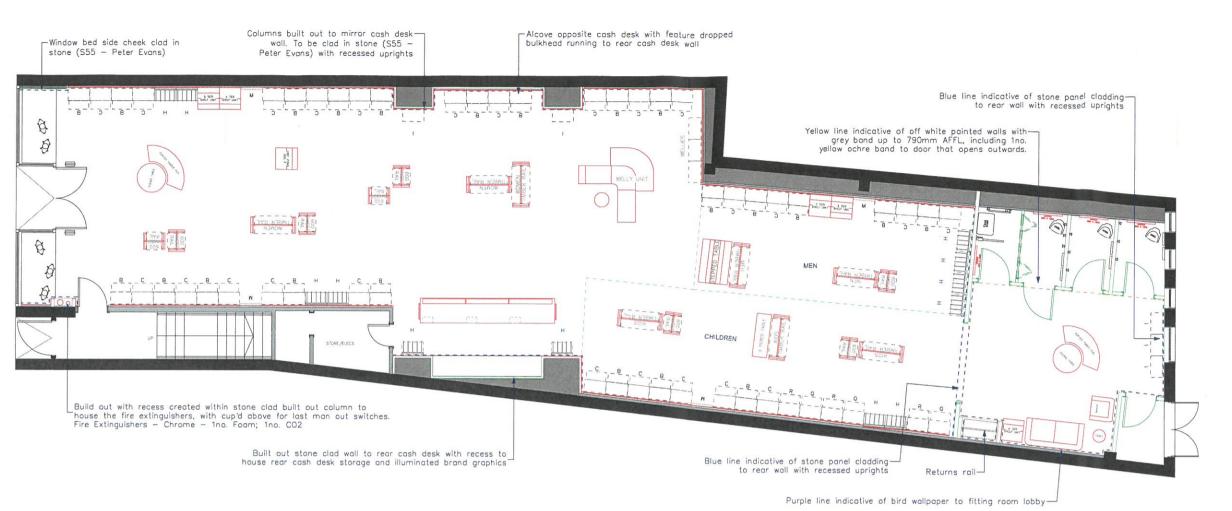

GROUND FLOOR

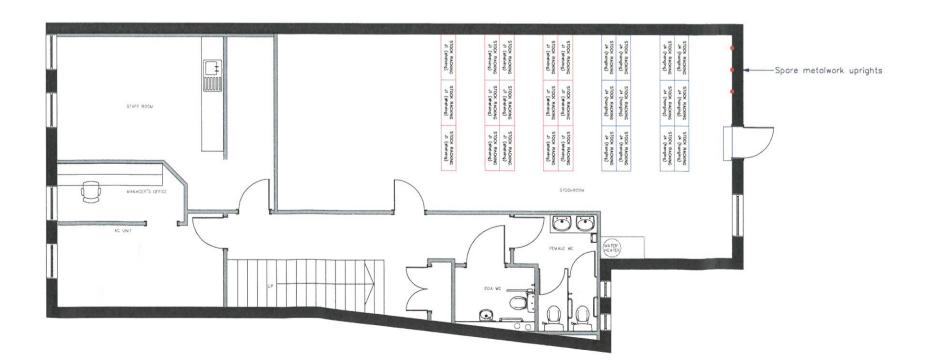

GENERAL NOTES

This drawing is the property of RPF Projects ltd and is not to be copied, reproduced, retained or disclosed to any unauthorised person, either wholly, electronically or in part without the written consent of RPF Projects ltd.

ILLUSTRATED BRIEF

ILLUSTRATED BRIEF

Any drawing prefixed with L1 in the drawing title block
must not in any way be used on site as a construction
drawing or used for final detailed costing.

MAINTENANCE NOTES

Dulux Off-White Vinyl Matt [98YY 82/022]*
BULKHEAD WALLS Dulux Light Grey Vinyl Matt [00NN 53/000] CEILING Dulux Brilliant White Vinyl Matt SKIRTING Dulux Dark Grey Eggshell [00NN 07/000] OTHER DECORATIVE TRIM** Dulux Off-White Eggshell [98YY 82/022] BACK WRAP WALL Dulux Off-White Vinyl Matt [98YY 82/022]

WALLS inc. STONE FACED SECTIONS

OFF WHITE LIGHT GREY

Total Shop Floor Area*	2317 sqft	
Total BOH Area**	1426 sqft	-
Total Stock Area***	708 sqft	30.6 %
TOTAL AREA	3900 sqft	
WOMENS	1632 sqft	70.4 %
MENS	283 sqft	12.2 %
CHILDRENS	402 sqft	17.4 %
Linear Capacity****	291 ft	15.6 %

including window beds & fitting rooms not including WC Included in the total BOH area * to be read in conjunction with Linear Ca

Conservation Area ab AS BUILT 27/09 Date

19-20 East St CHICHESTER PO19 1HS

AS BUILT Ground & First Floor General Arrangements

27/09/17 1/50@A1 - 1/100@A3 02-154 DJC 02-154-100 ab



Unit B, Bassingbourn Gashouse, 70 High Street, Bassingbourn, Royston, Hertfordshire SG8 5LF T: 01763 243664 E: info@rpfprojects.com www.rpfprojects.com

FIRST FLOOR